


SCOPE OF WORK

NOT IN SCOPE OF WORK

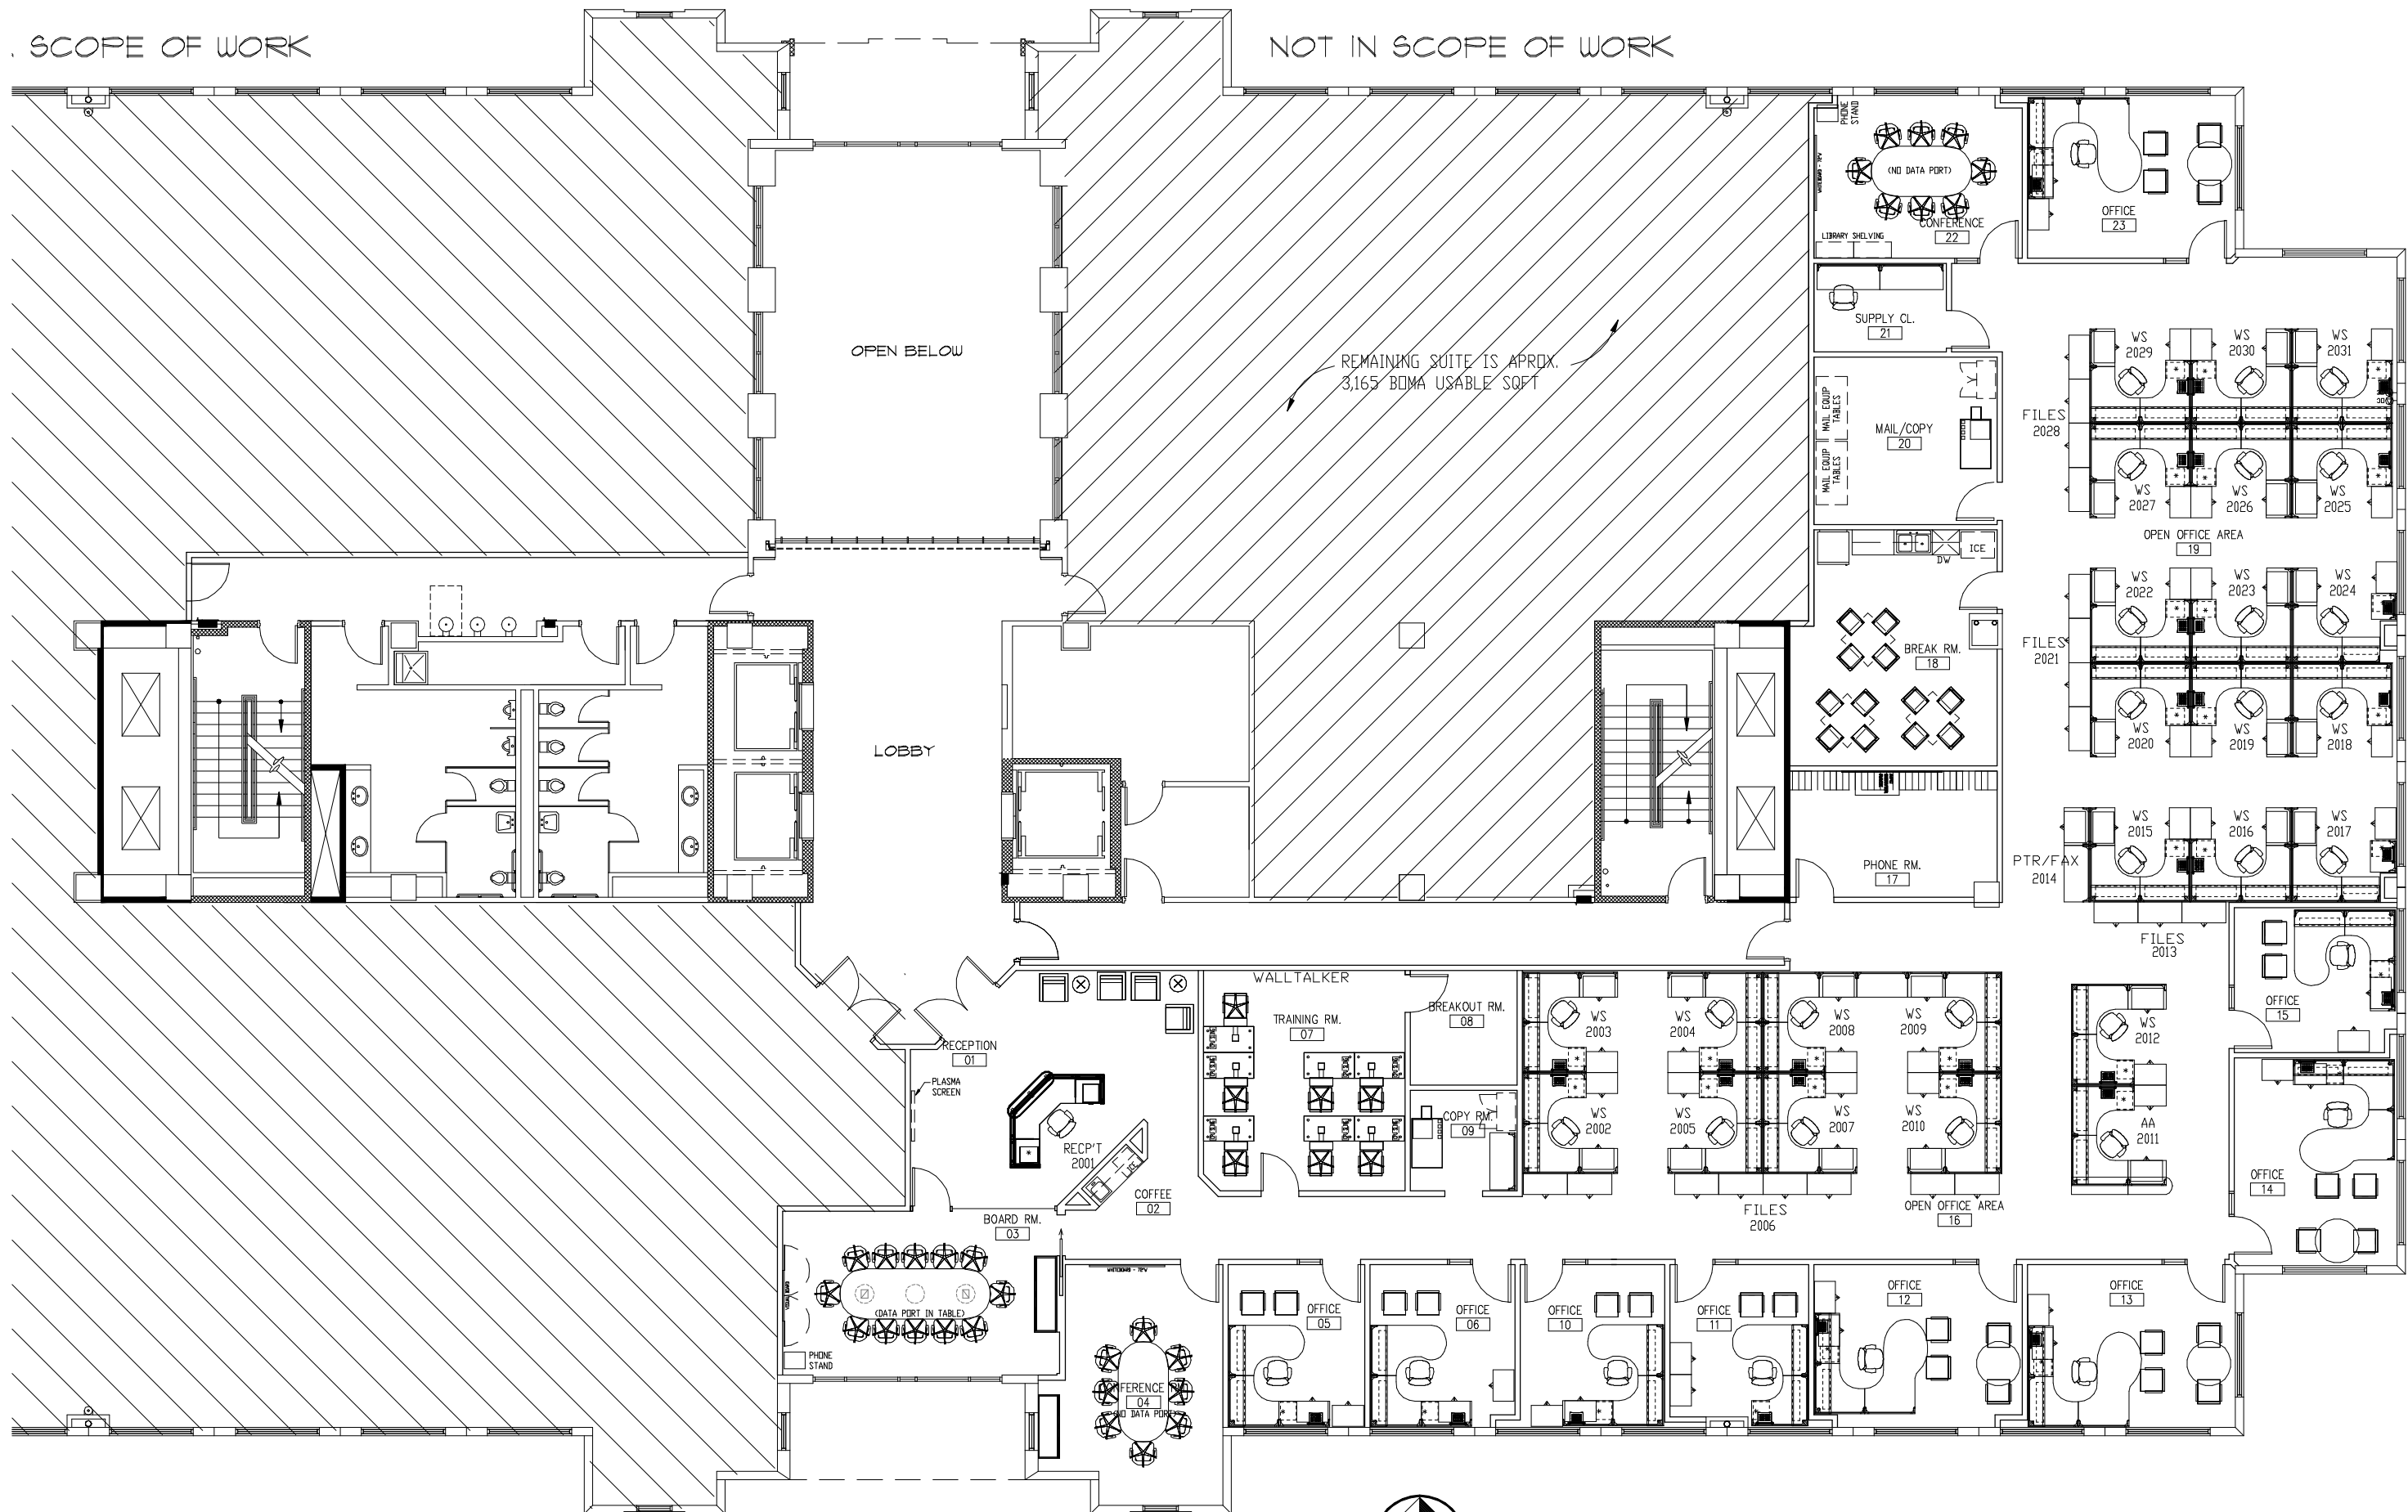

2ND FLOOR PLAN

SCALE: 1/8"=1'-0"

APPROX. 7,420 BOMA USABLE SQFT

MIRAMAR CENTER III

DATE: 01/26/07